



NEW PUMP HOUSE
TO LOCATION SHOWN
BY DASHED LINE
IF FOUNDATION
IS FOUND TO BE
UNSATISFACTORY
FOR THIS USE

PLOT PLAN SCALE 1/8"=1'-0"

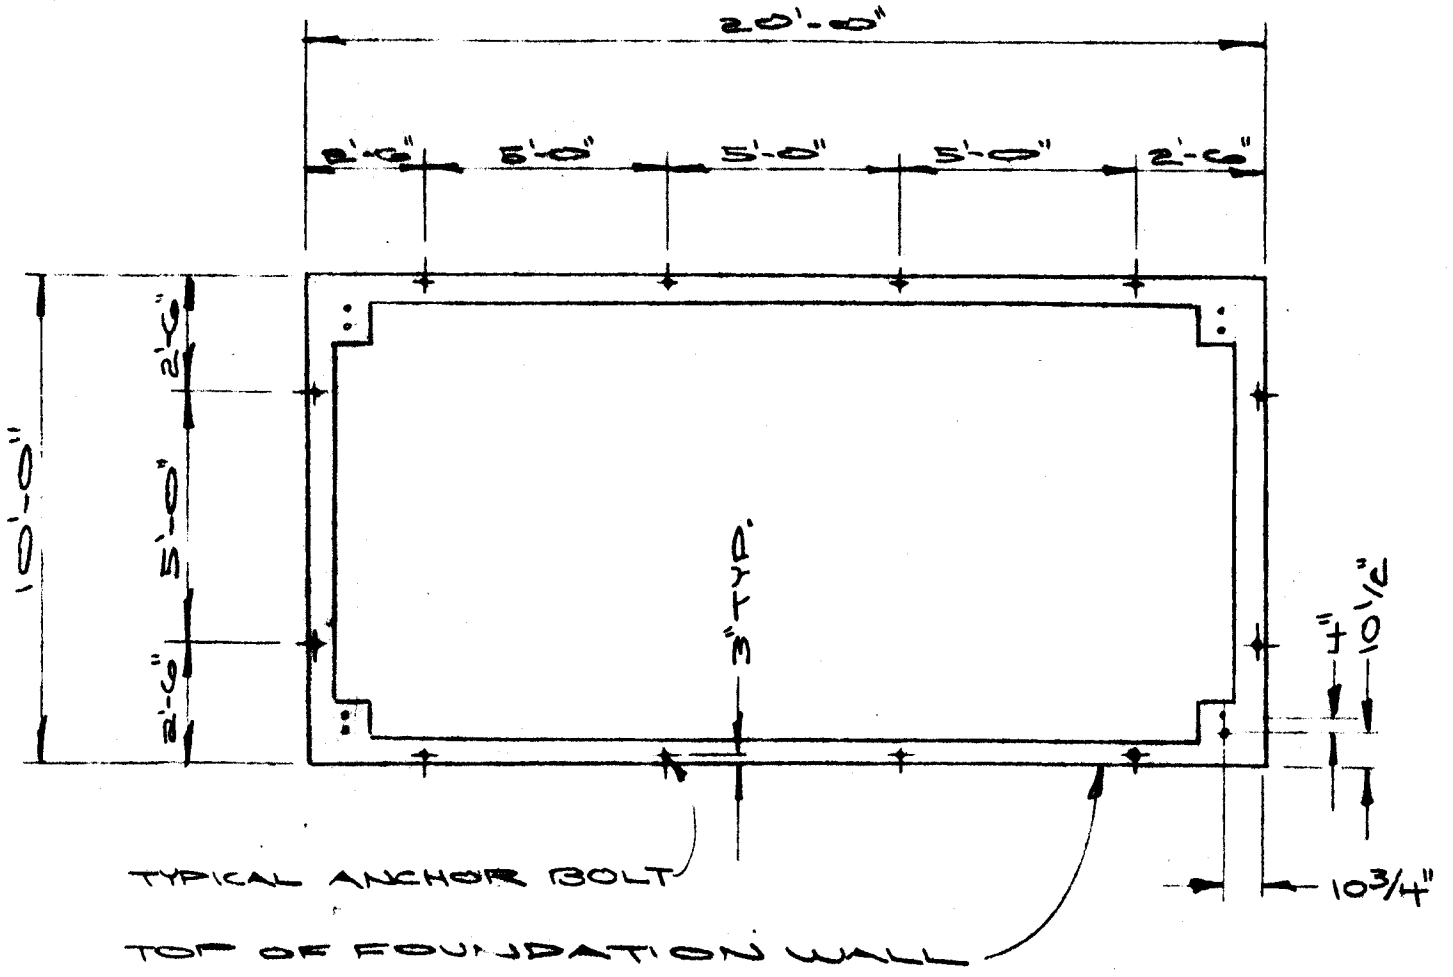

ANCHOR BOLT PLAN
SCALE 1/4"=1'-0"


- NOTE:**
1. ANCHOR BOLT LOCATION IS FOR BUTLER TYPE STEEL BUILDING.
 2. CONTRACTOR TO INSTALL ANCHOR BOLTS FURNISHED BY OTHERS AND TO TEMPLATE SETTING TO SUIT TYPE OF STEEL BUILDING FURNISHED BY OTHERS.

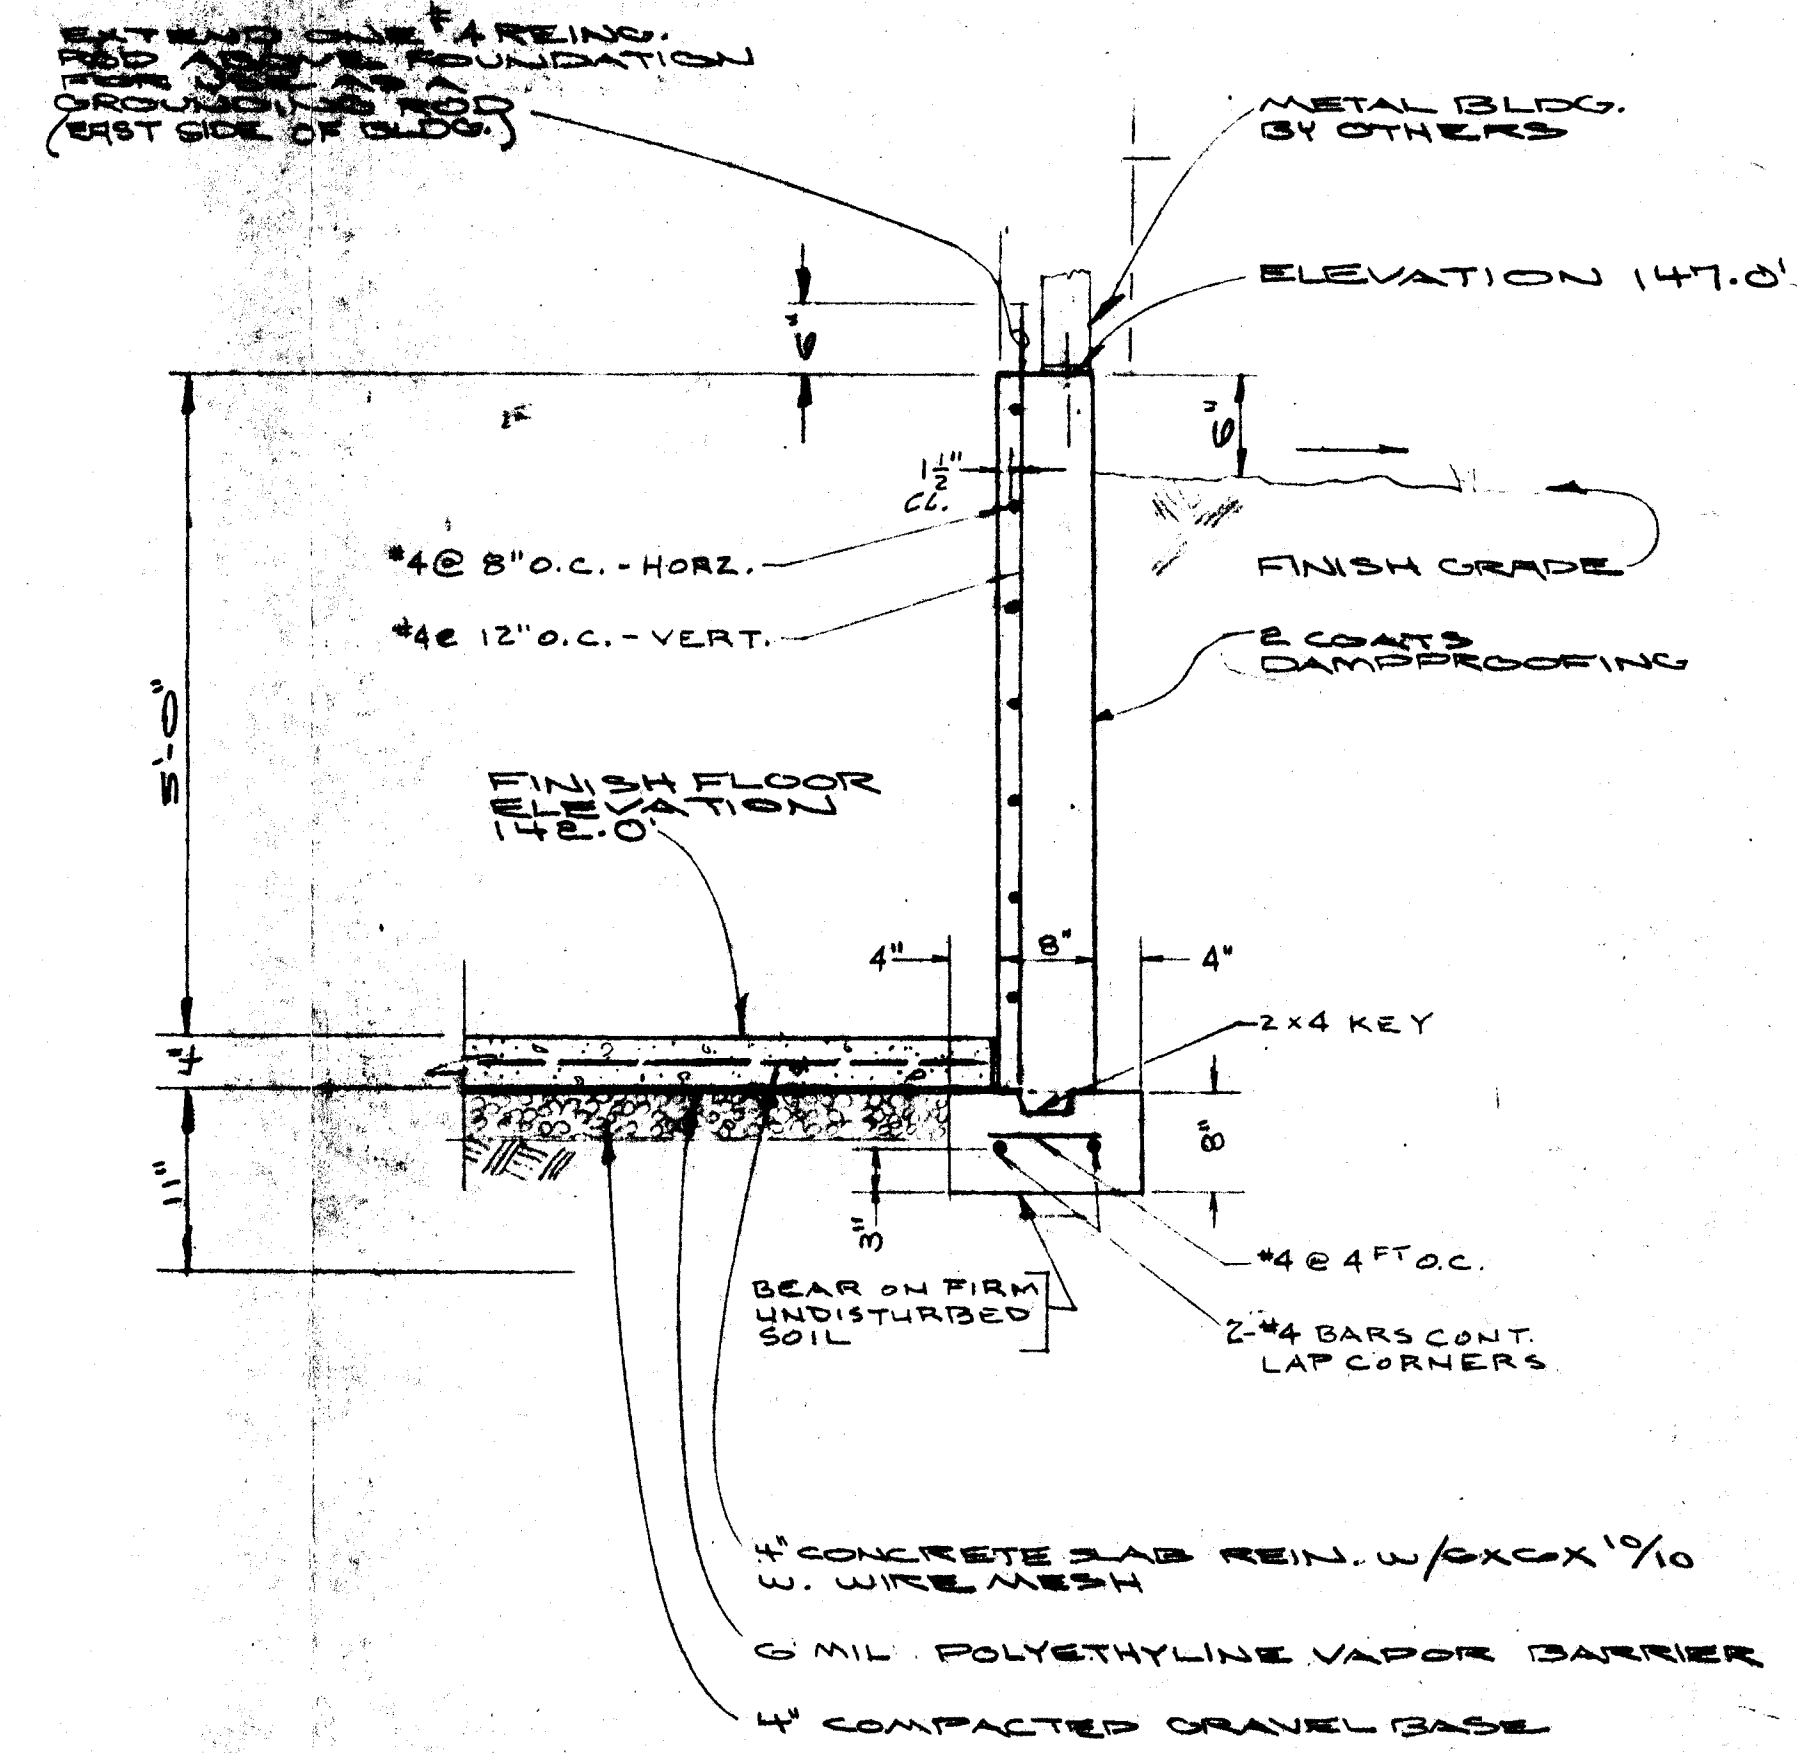

SECTION A-A SCALE 3/4"=1'-0"

SPEC. & GENERAL NOTES:


1. CEMENT: 3000 PSI @ 28 DAYS; ASTM C94-C9
2. REIN. STEEL: INTERMEDIATE GRADE, DEFORMED BARS; GRADE 40; COMPLY WITH REQUIREMENTS OF ASTM A305 & A408
3. INSTALL CORNER BARS AT ALL HORIZ. REIN.; LAP BARS AND SPLICES 24 BAR DIA., MIN. 12"
4. PLACE FLOOR SLAB AND CURE BEFORE BACKFILLING WALL

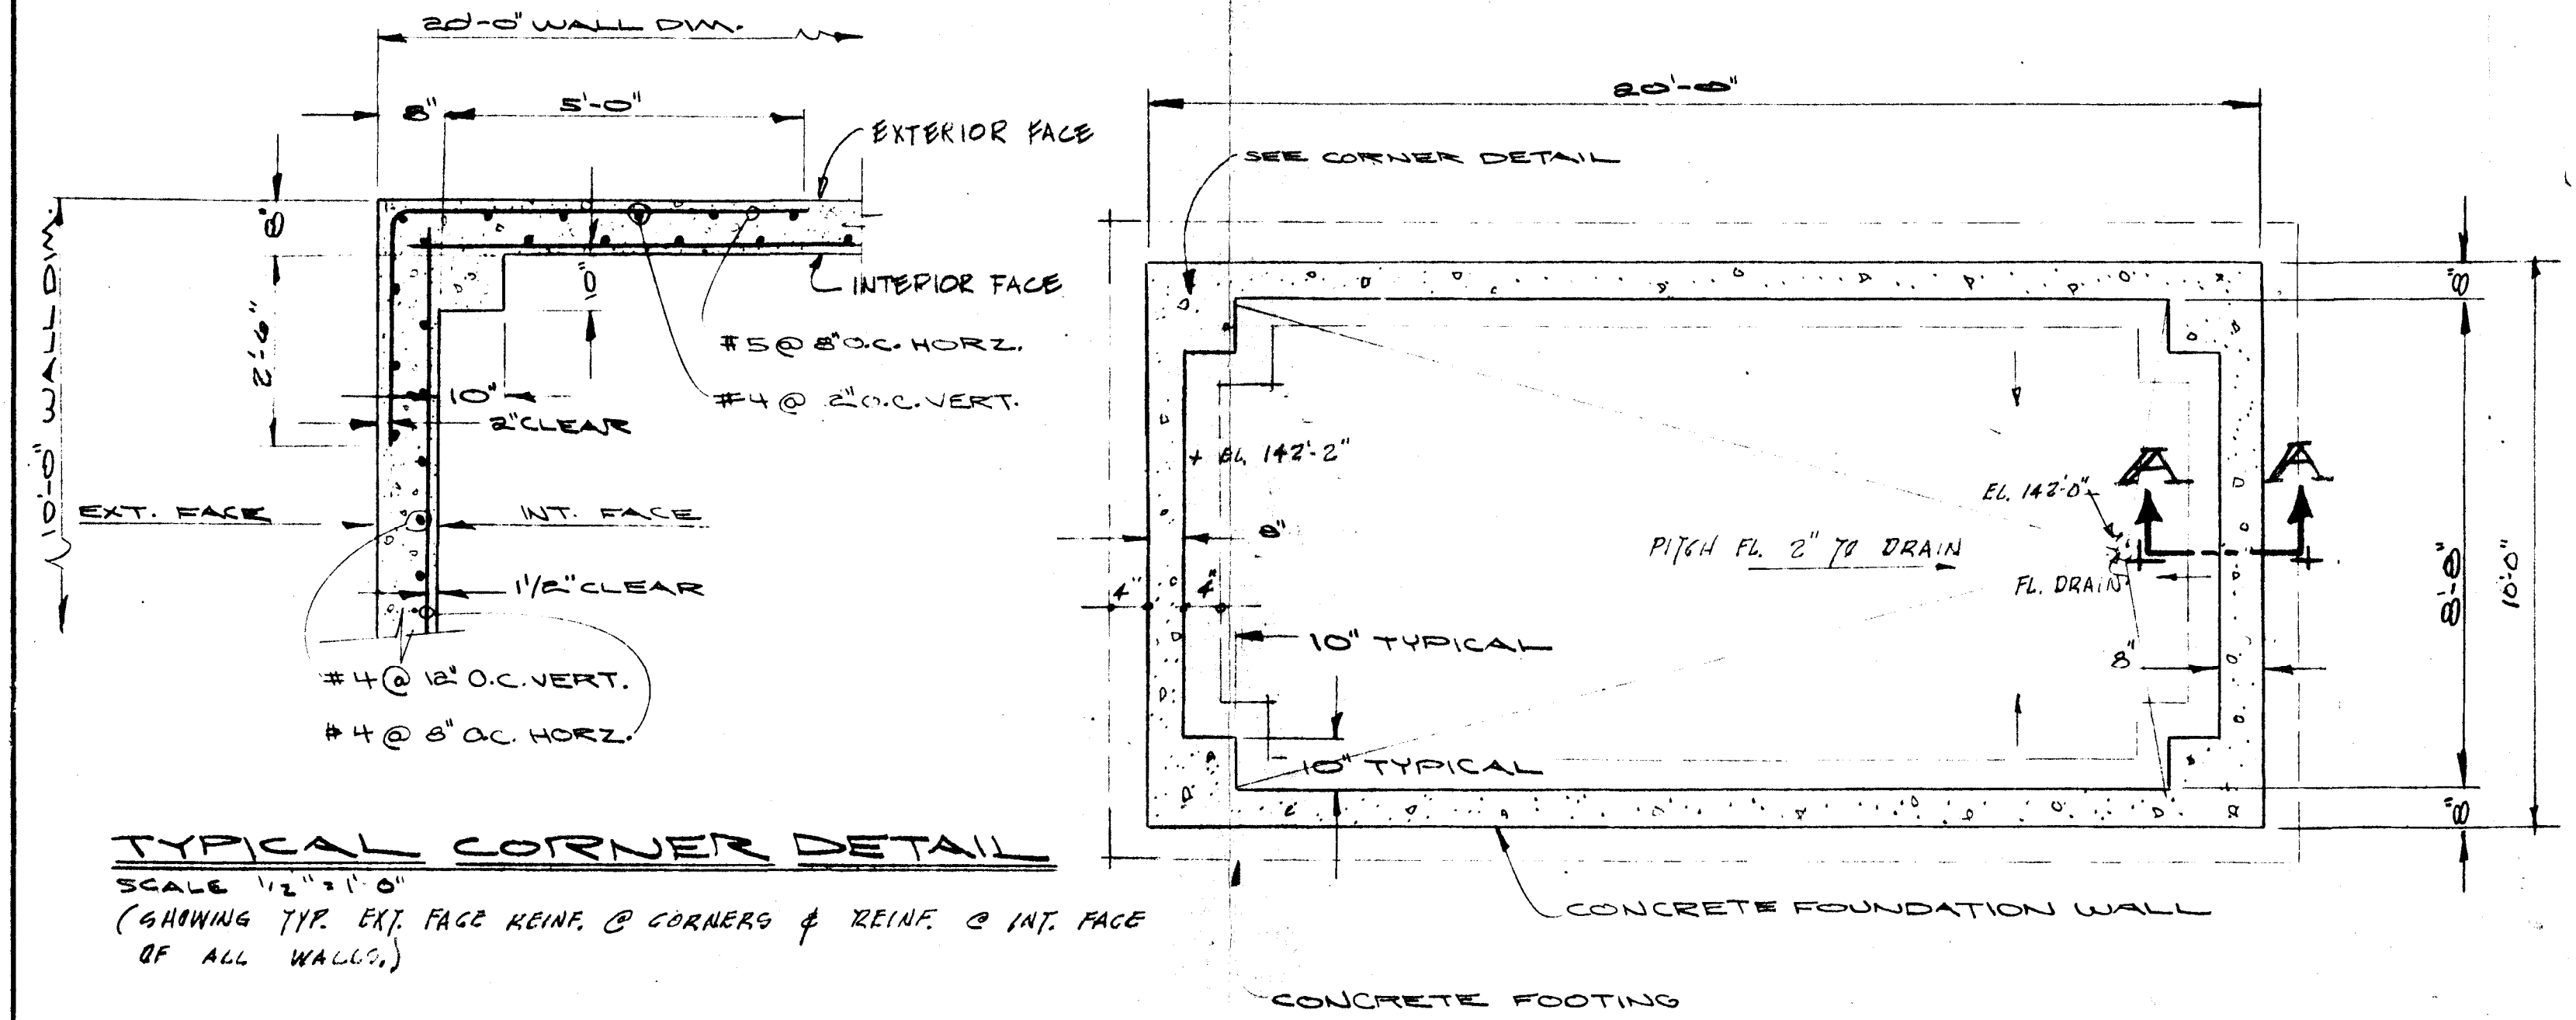

TYPICAL CORNER DETAIL

SCALE 1/2"=1'-0"
(SHOWING TYP. EXT. FACE REIN. @ CORNERS & REIN. @ INT. FACE OF ALL WALLS.)

FOOTING & FOUNDATION PLAN SCALE 3/8"=1'-0"

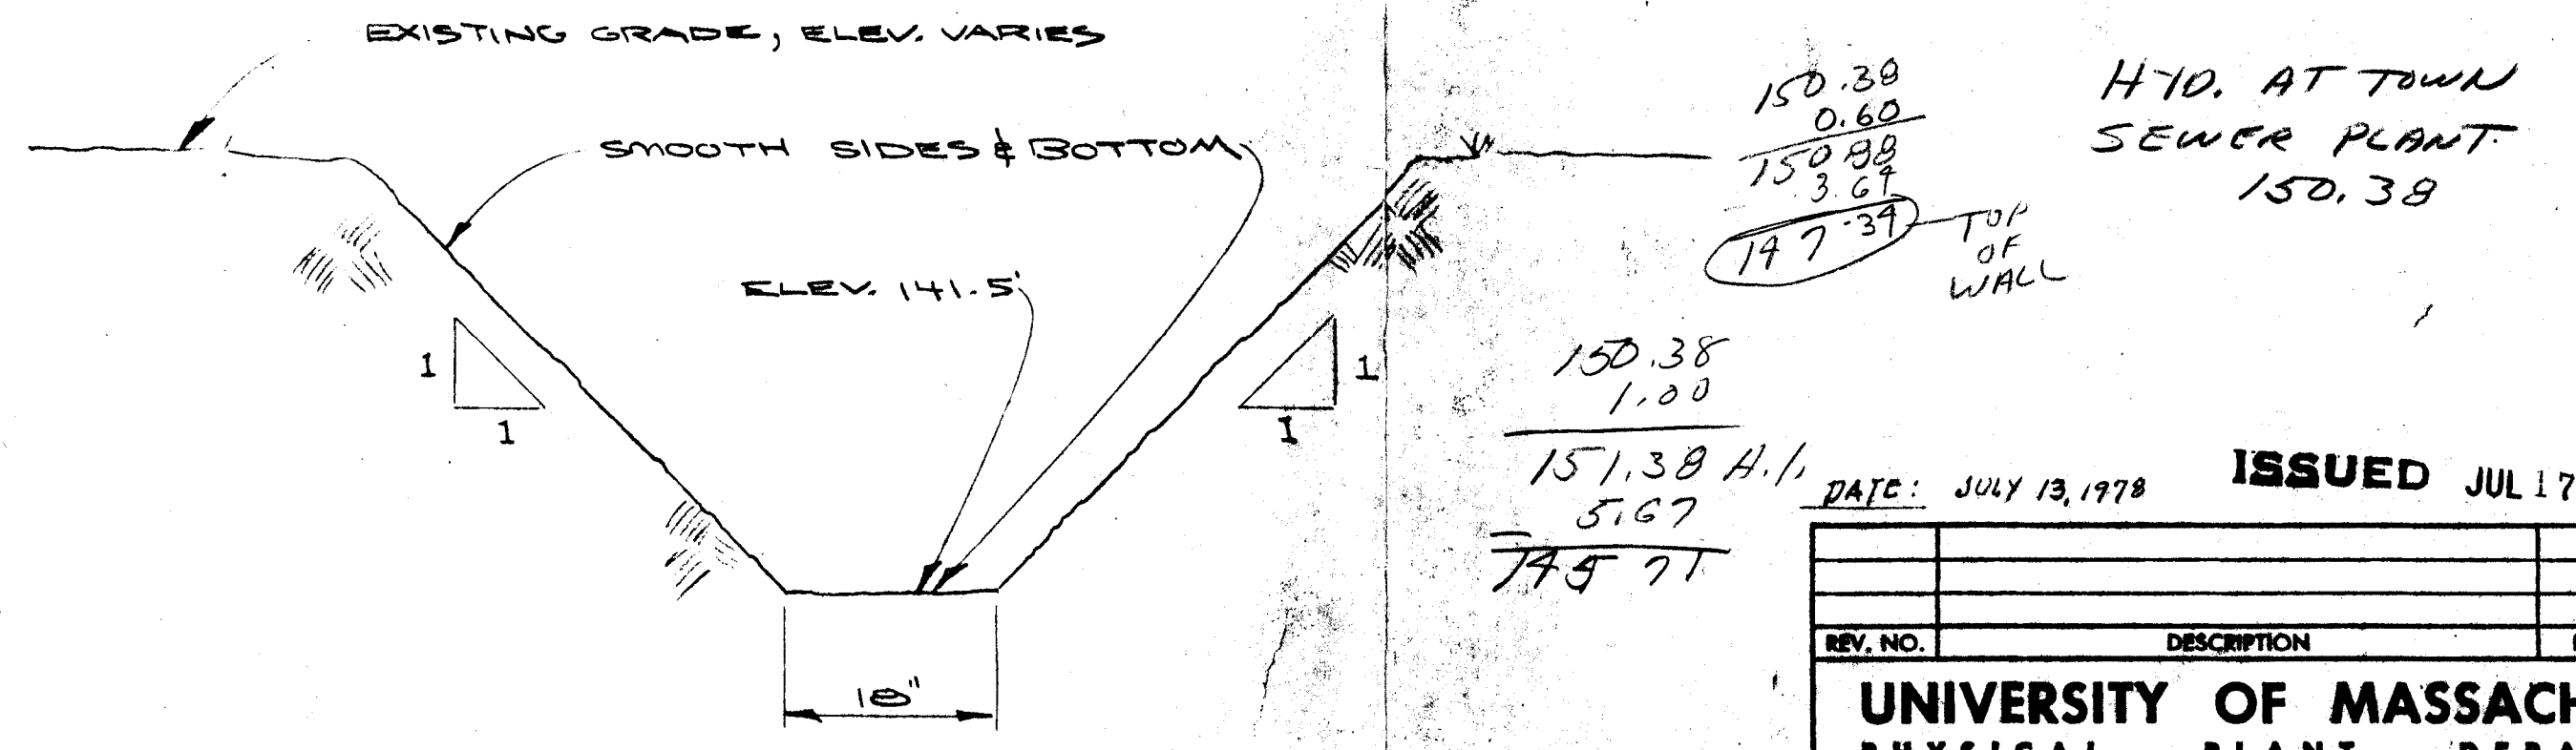

SECTION B-B THRU NEW TRENCH SCALE 3/4"=1'-0"

DATE: JULY 13, 1978 **ISSUED JUL 17 1978**

REV. NO.	DESCRIPTION	BY	APPD.	DATE

UNIVERSITY OF MASSACHUSETTS
PHYSICAL PLANT DEPARTMENT

10' X 20' PUMP HOUSE
WASTEWATER SUPPLY PROJECT

BY	DATE	APPD.	DATE	WORK ORDER NO.	PROJ. CONTRACT NO.
DRN.	6/16/78			WT058-15	DMA 79-2
TRD.				SCALE AS SHOWN	SHEET 1 OF 2
CKD.	7-12-78			DRAWING NUMBER	
DES.	7/13/78			D-A-000-W7658R-A1	

FILE LOCATION